




VICINITY MAP BLDG

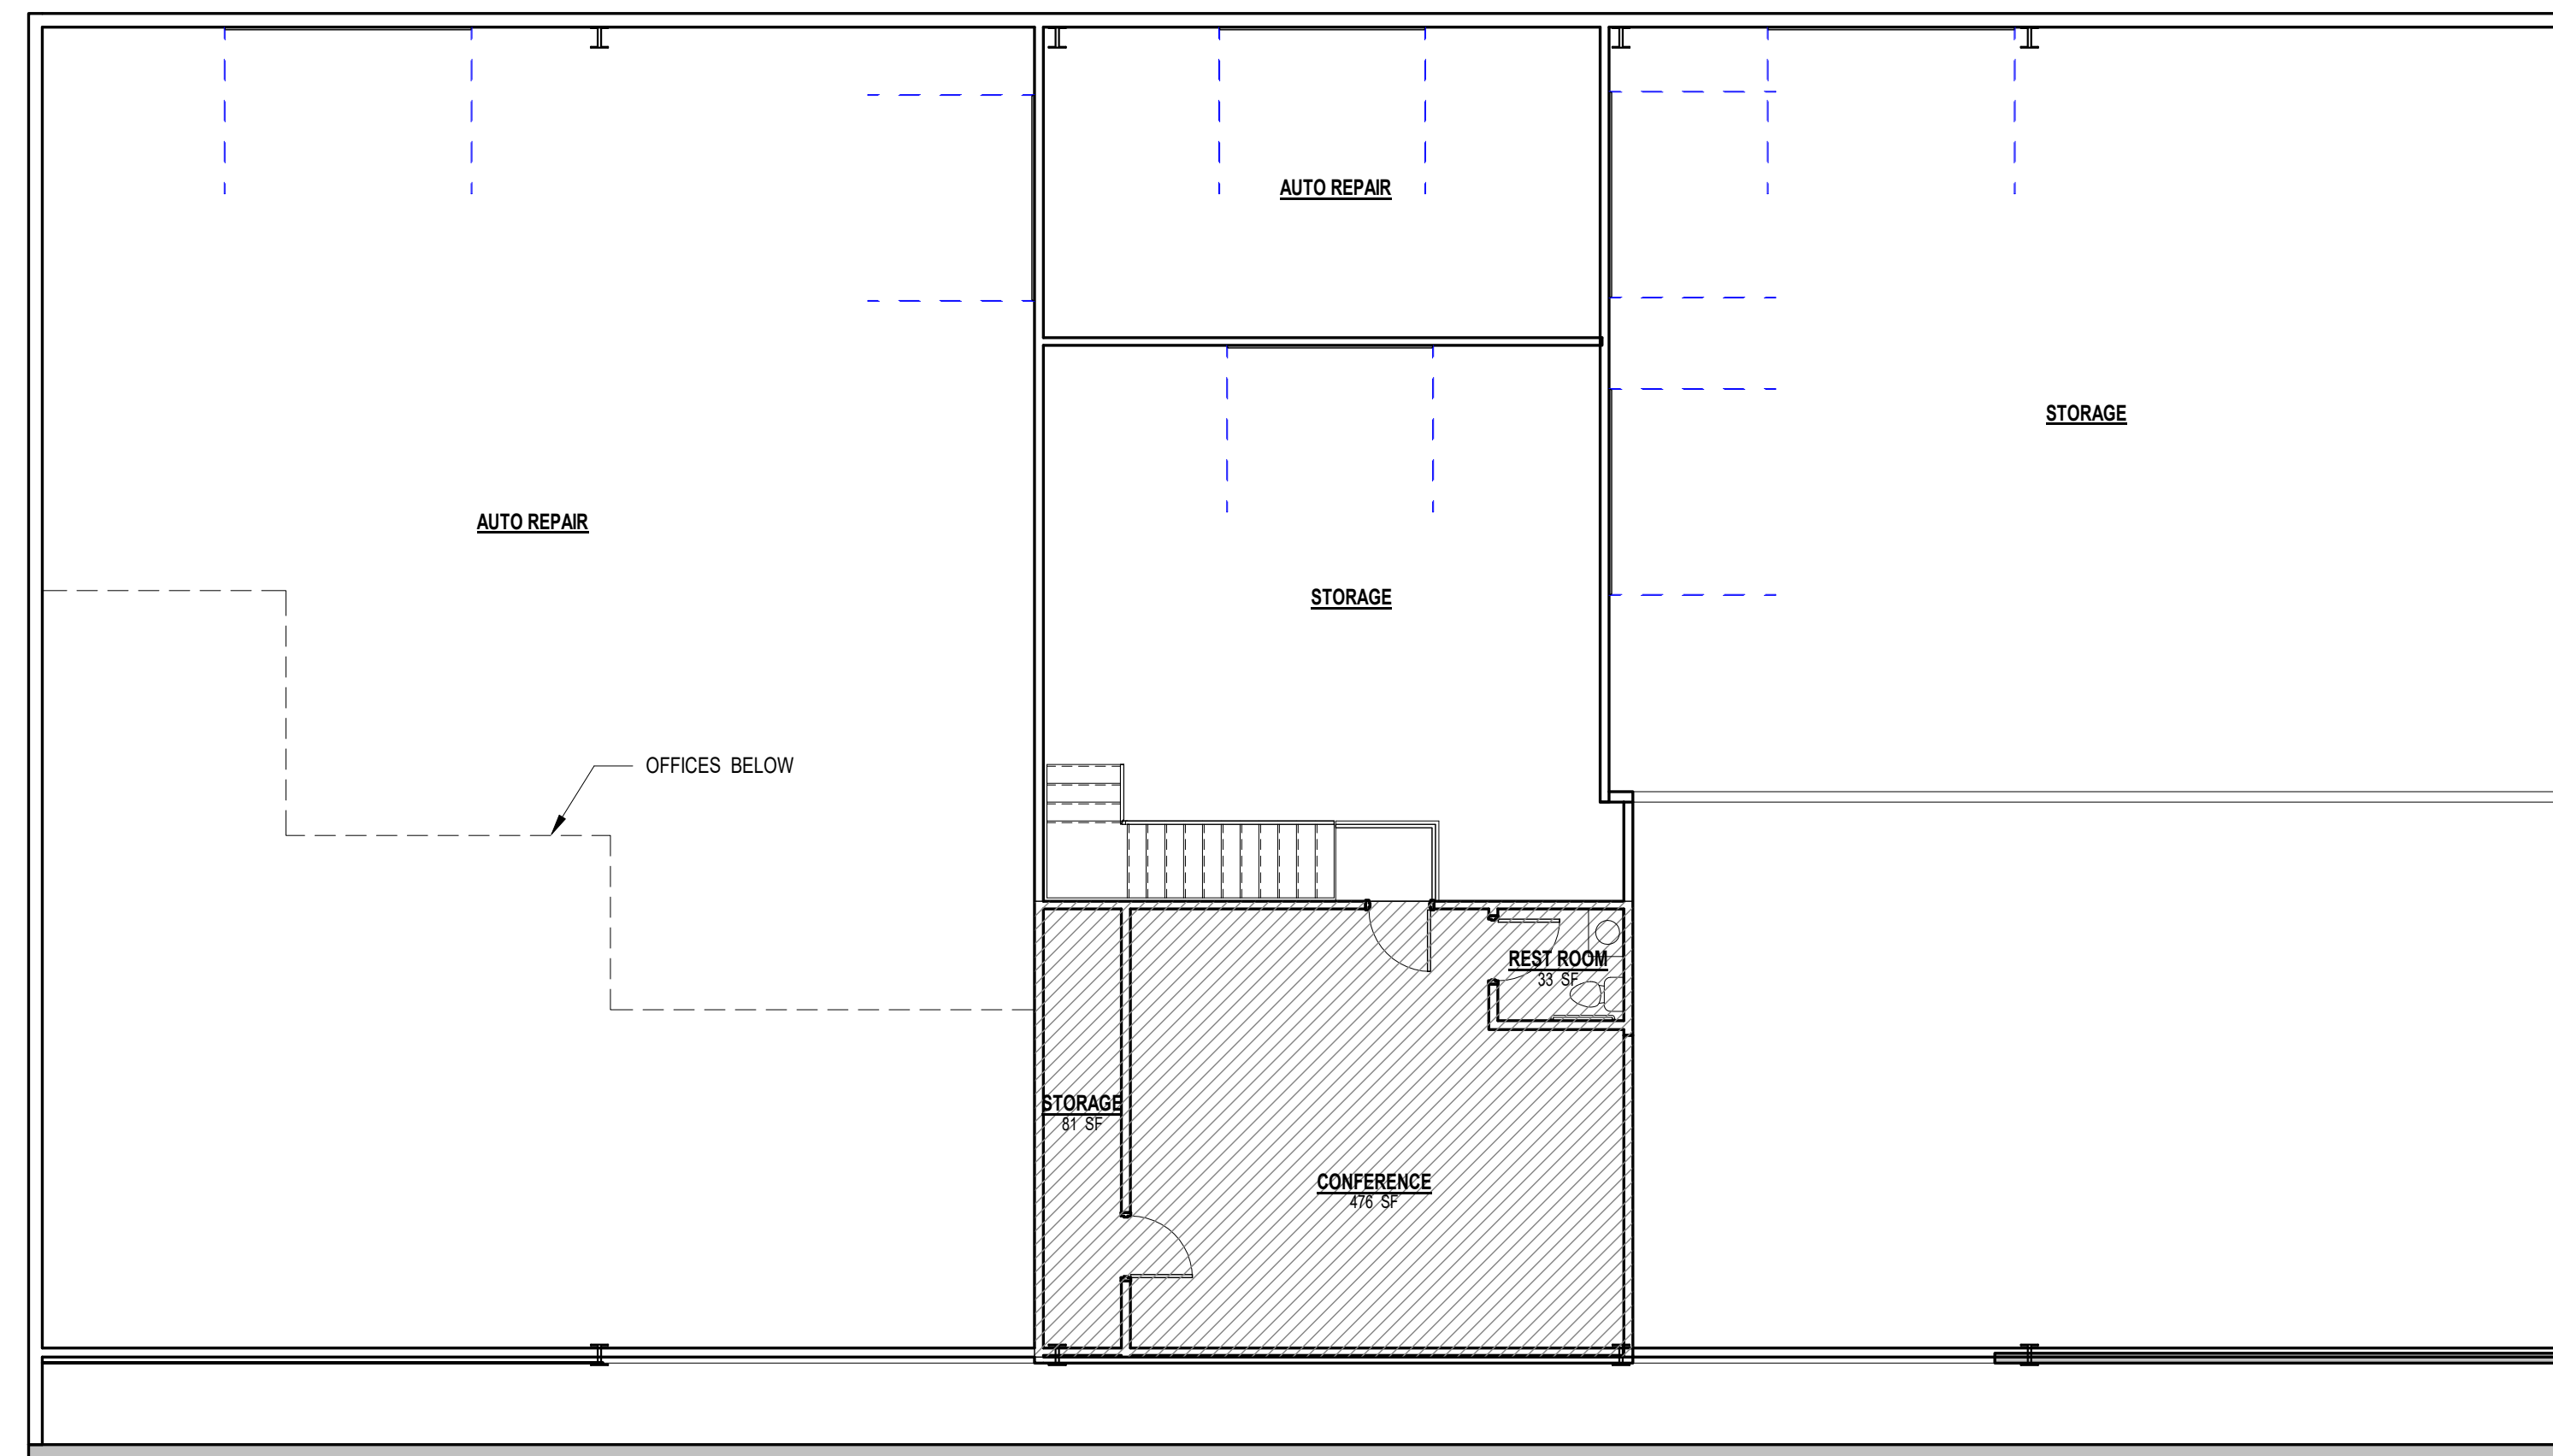

2 AREA PLAN - LEVEL 2  
1/8" = 1'-0"

TENANT "B": 650 SF


**PROJECT INFO**

TENANT "A" - INSULATION COMPANY  
INDUSTRIAL OCCUPANCY PER NFPA 101 (2018 EDITION)  
2963 SF TOTAL AREA

TENANT "B" - AUTO MECHANIC  
INDUSTRIAL OCCUPANCY PER NFPA 101 (2018 EDITION)  
6016 SF TOTAL AREA (2 LEVELS)

REVISIONS	DATE	DESCRIPTION
AS-BUILTS	02/10/2023	
1 REV 1	02/17/23	

NOT ISSUED FOR CONSTRUCTION.

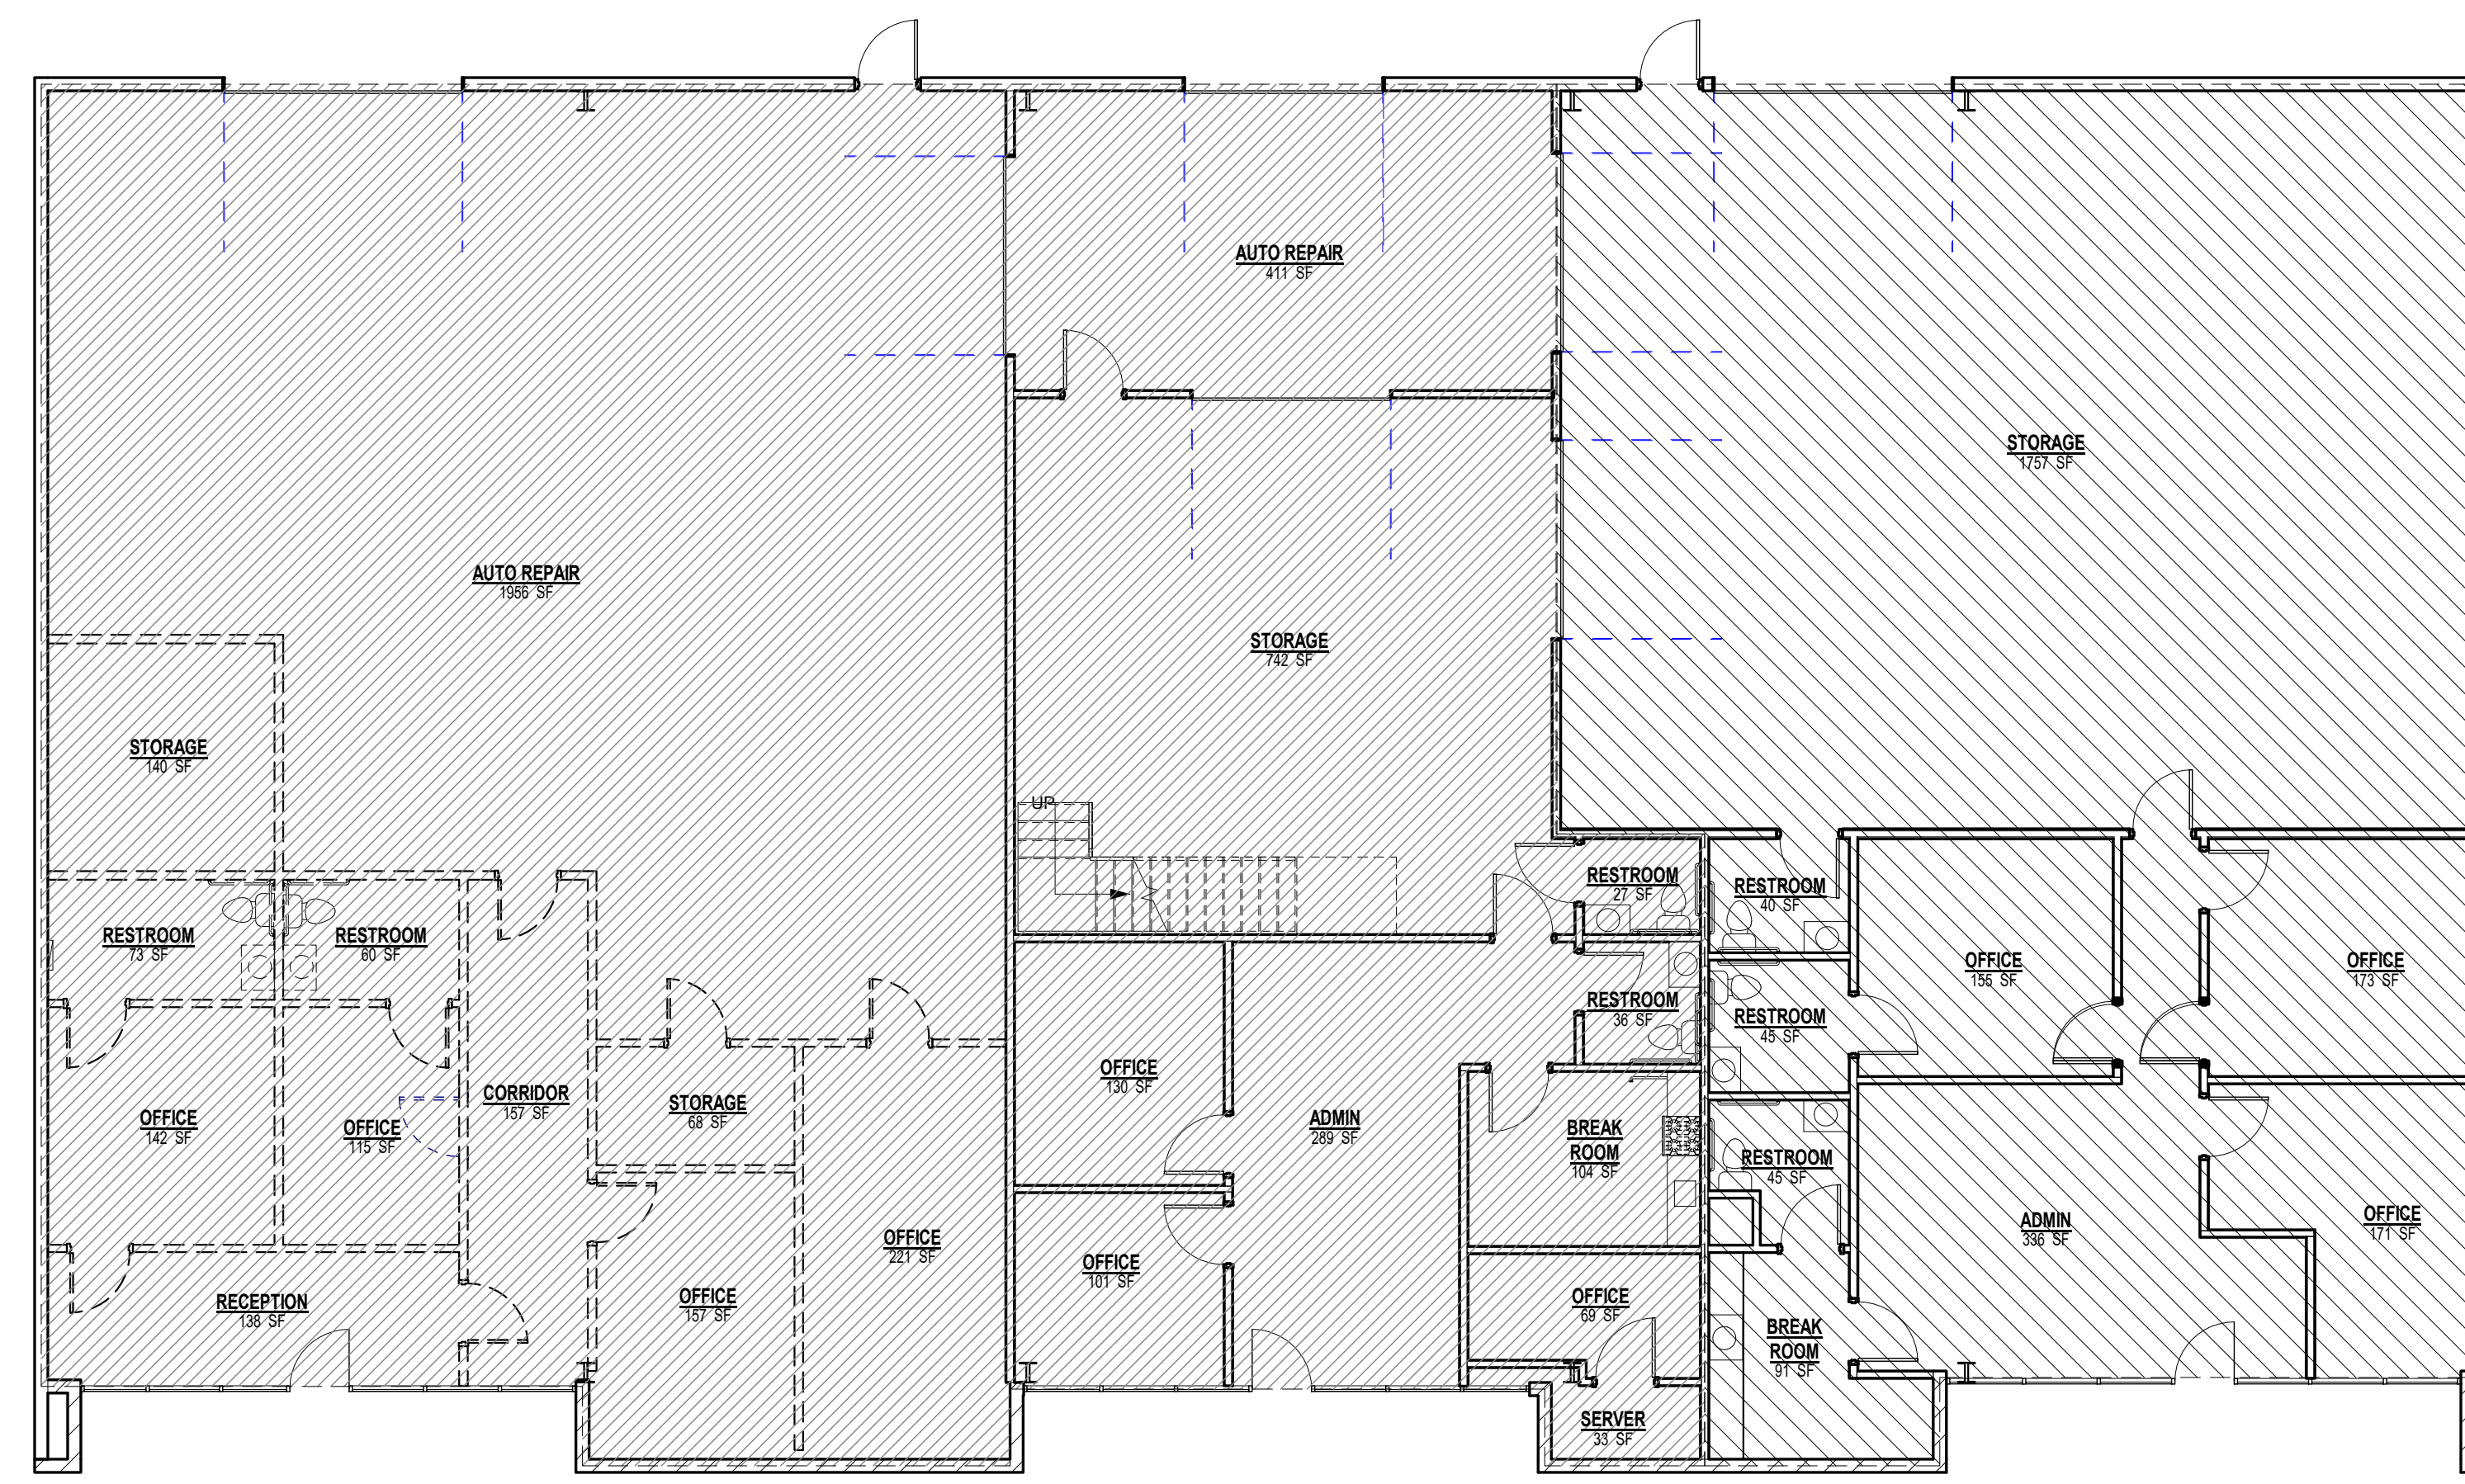

1 AREA PLAN - LEVEL 1  
1/8" = 1'-0"

TENANT "B": 5366 SF

TENANT "A": 2963 SF

REVISION SUMMARY  
1. NEW SHEET

2317 DANBURY LANE,  
GAINESVILLE, GA

AS-BUILT DRAWINGS

COVER SHEET


REVISIONS	DATE	BY	DESCRIPTION
AS-BUILTS	02/10/2023		
1 REV 1	02/17/23		

NOT ISSUED FOR CONSTRUCTION

2317 DANBURY LANE,  
GAINESVILLE, GA

AS-BUILT DRAWINGS

FLOOR PLANS

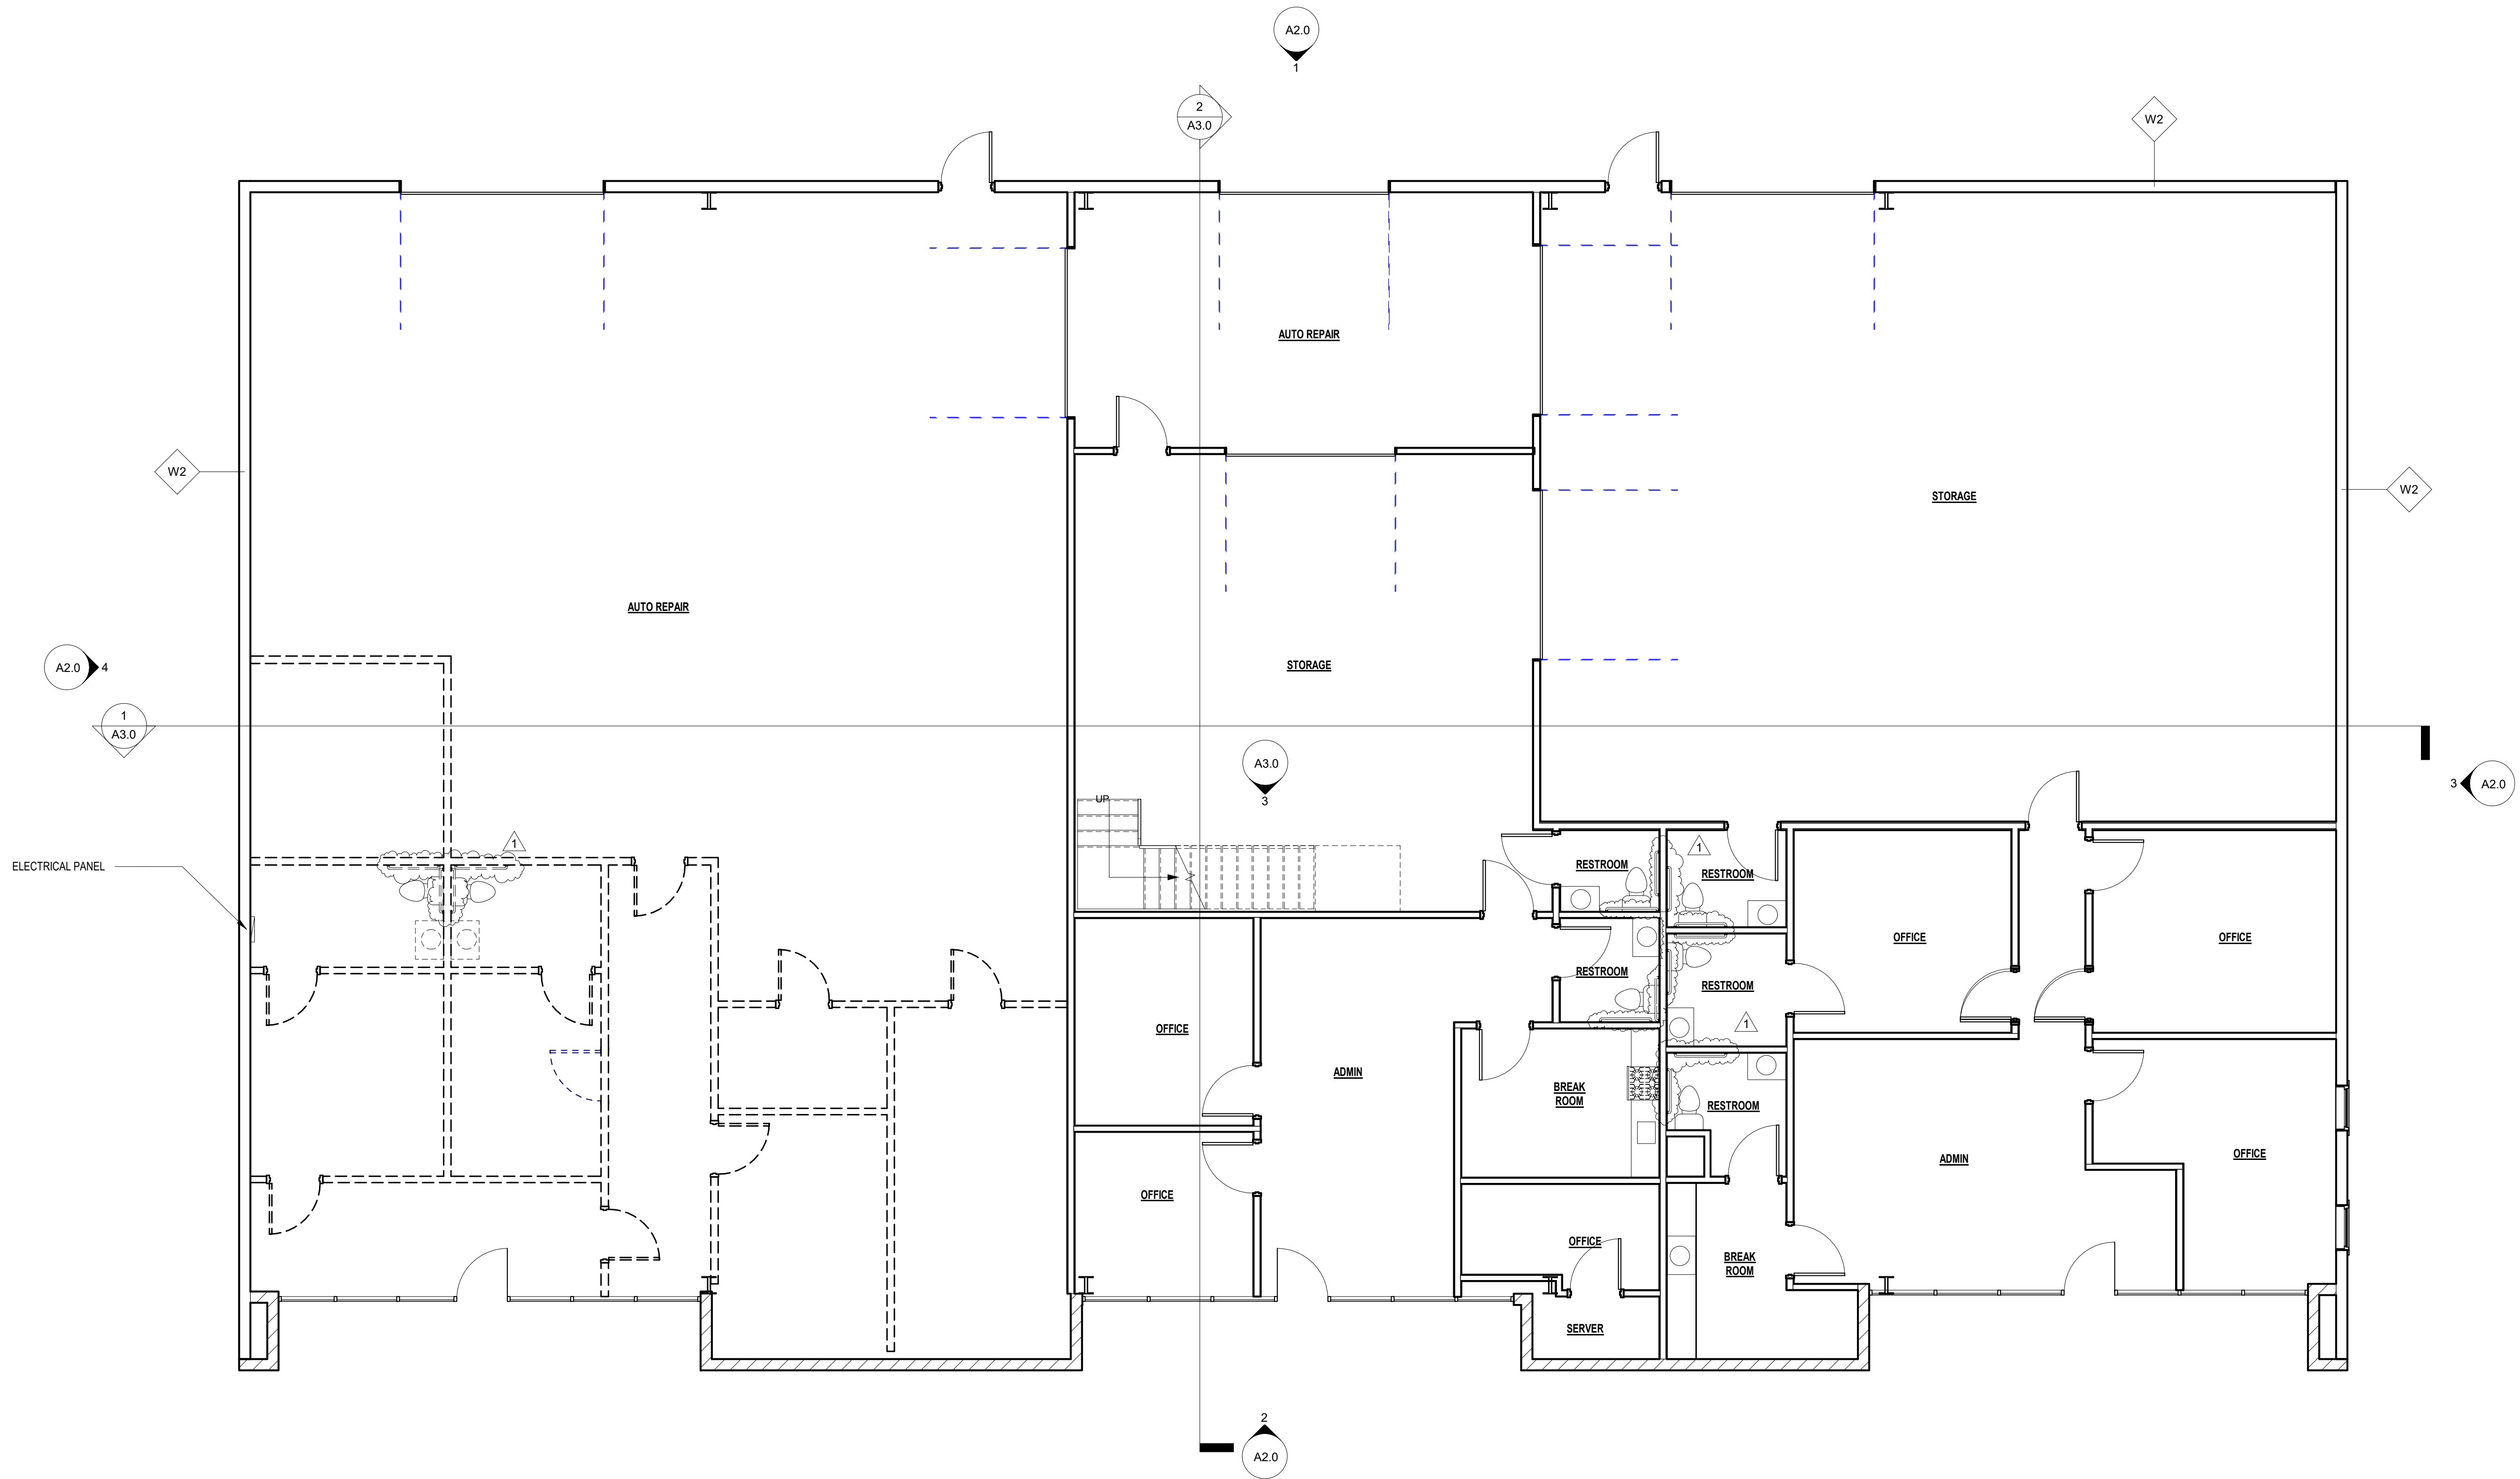

1 FLOOR PLAN  
3/16" = 1'-0"

NOTE:  
ALL RESTROOM GRAB BARS  
ARE +/- 34" A.F.F.

GROSS AREA: 8465 SF

REVISION SUMMARY  
1. SHOW GRAB BARS

WALL SCHEDULE	
<p>4" METAL STUDS 1/2" GYPSUM BRD, PAINT S&amp;B INSULATION</p>	<p>CORRUGATED METAL SIDING INSULATION</p>
<p>W1: 2X4 METAL STUD W/2 SIDES GYP BD</p>	<p>W2: PRE-MANUFACTURED METAL BLDG. EXTERIOR WALL</p>
<p>NOTE: ALL INTERIOR WALLS ON PLAN ARE "W1" UNLESS NOTED OTHERWISE</p>	

NO.	DATE	DESCRIPTION
1	02/10/2023	AS-BUILTS
	02/17/23	REV 1


NOT ISSUED FOR CONSTRUCTION

2317 DANBURY LANE,  
GAINESVILLE, GA

AS-BUILT DRAWINGS

FLOOR PLANS

A1.1




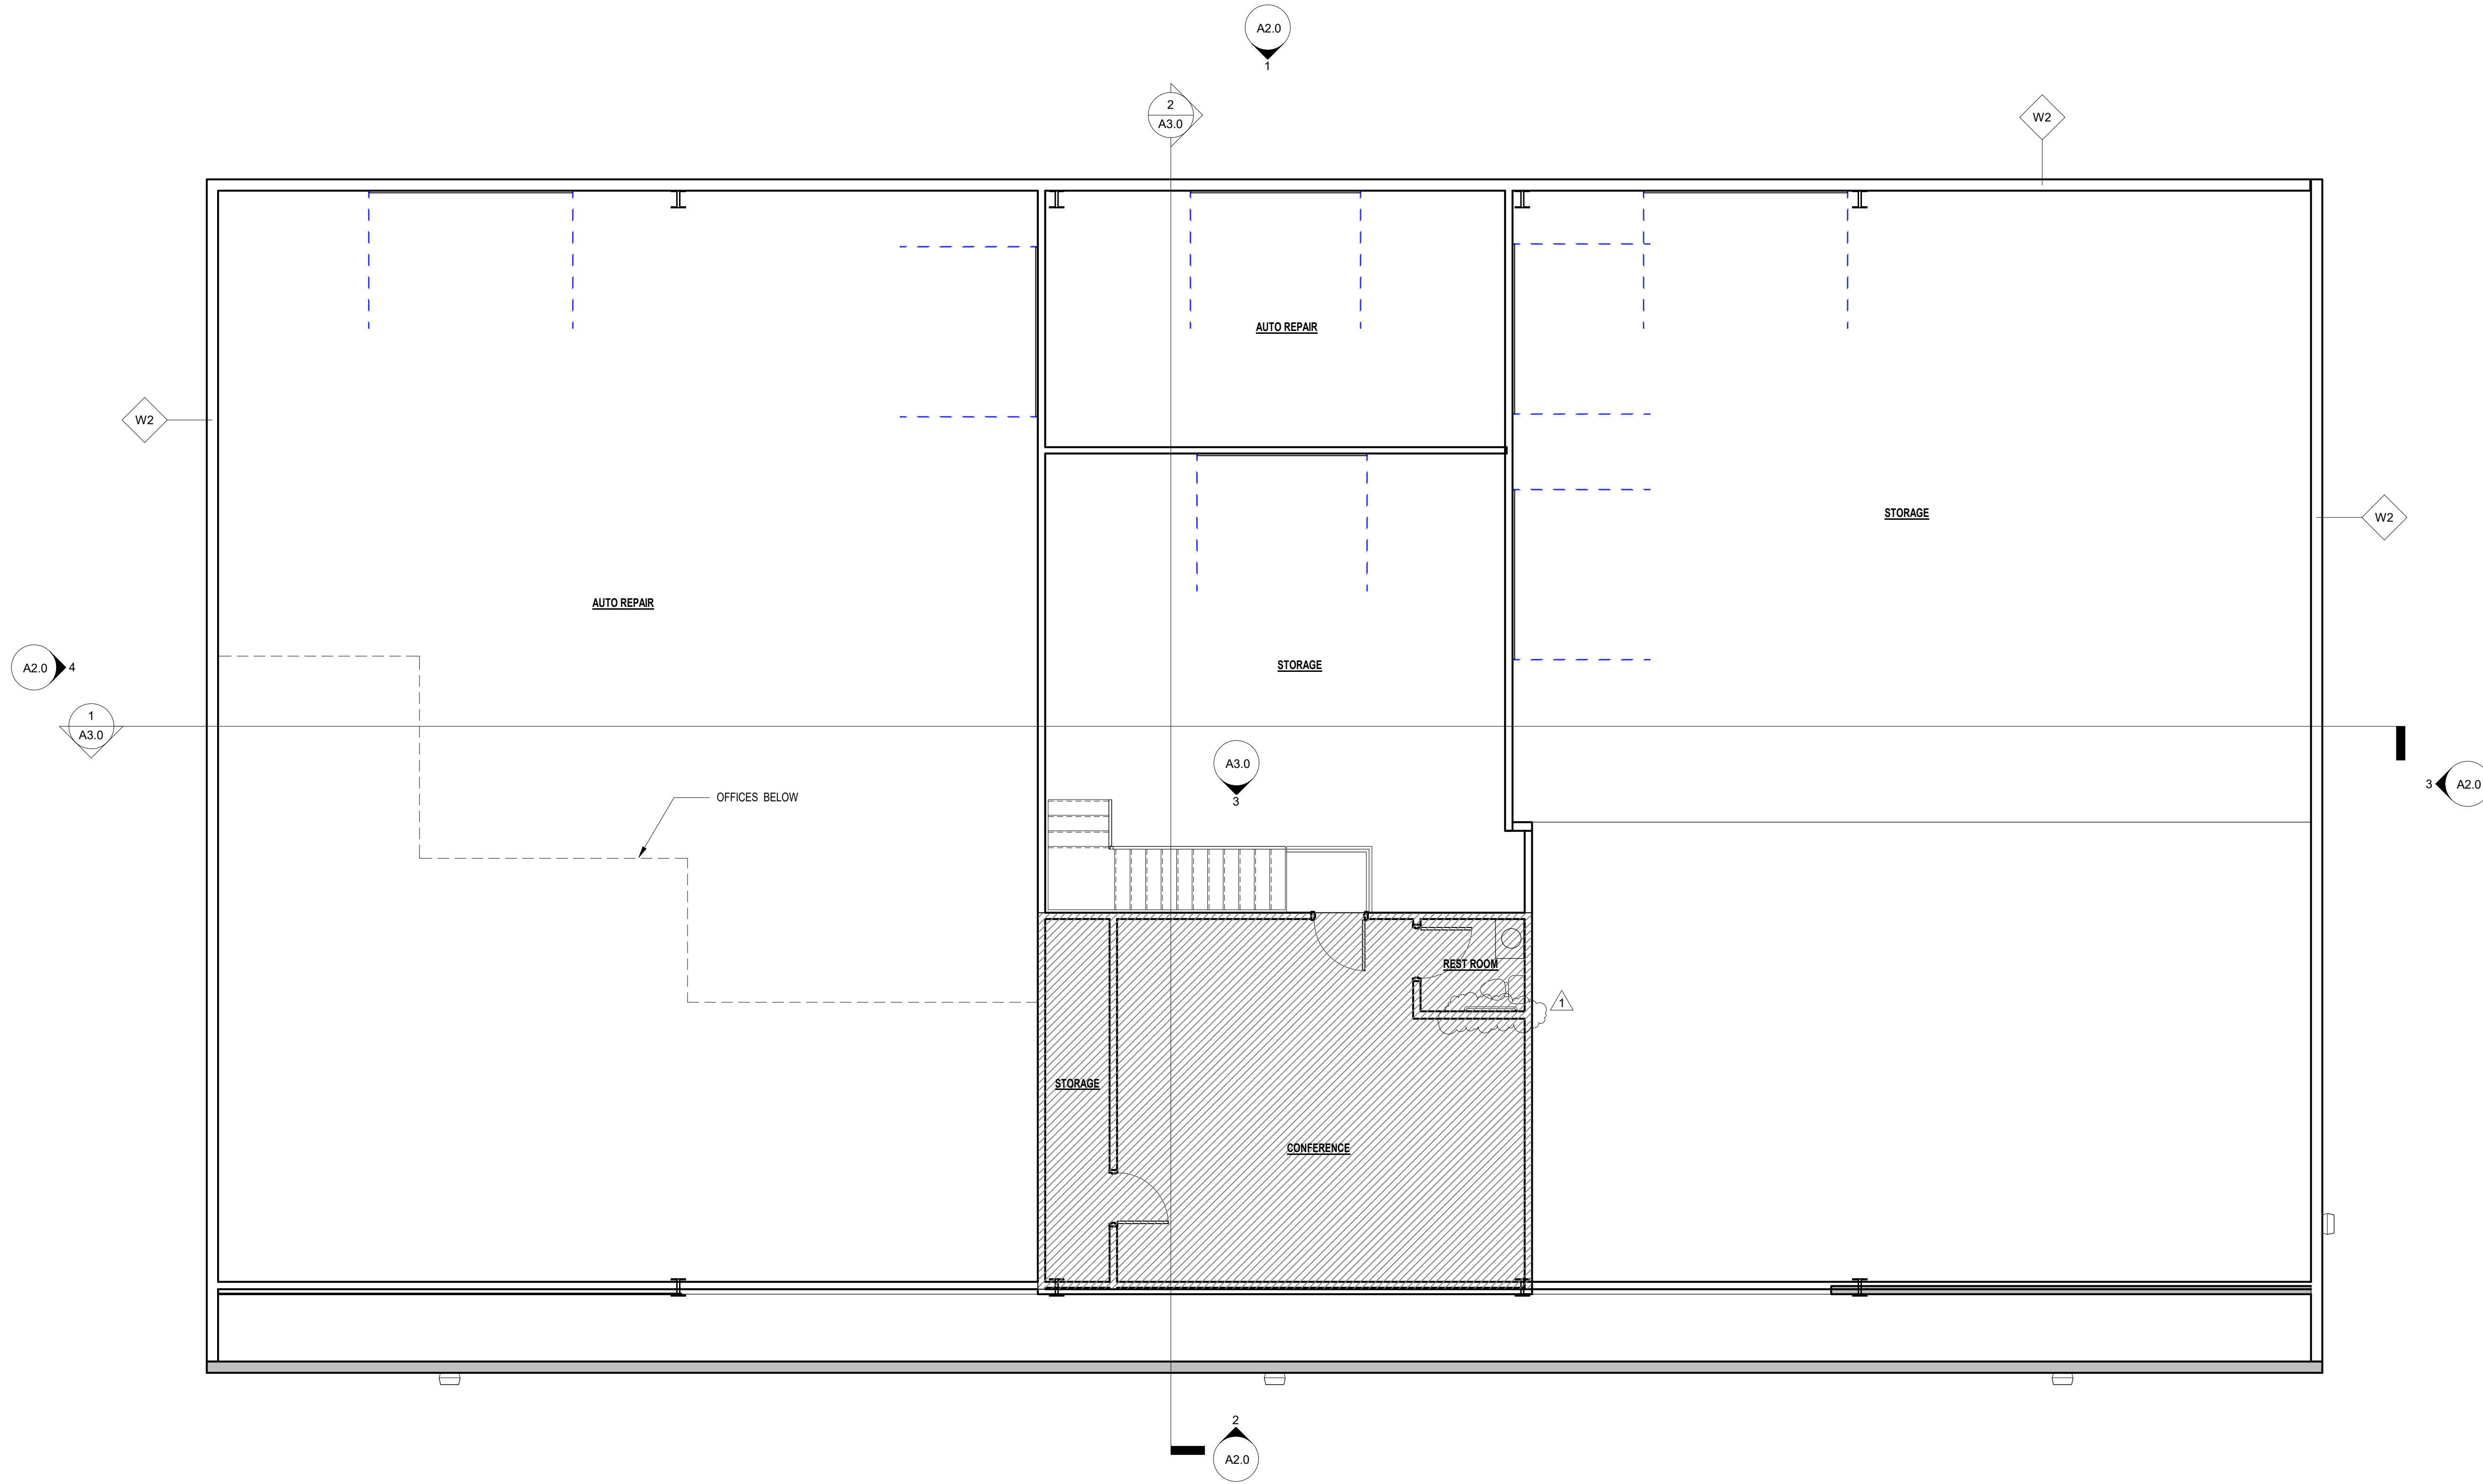


1 - 2ND FLOOR  
3/16" = 1'-0"

GROSS AREA (LEVEL 2) : 650 SF

NOTE:  
ALL RESTROOM GRAB BARS  
ARE 34" A.F.F.

REVISION SUMMARY  
1. SHOW GRAB BARS

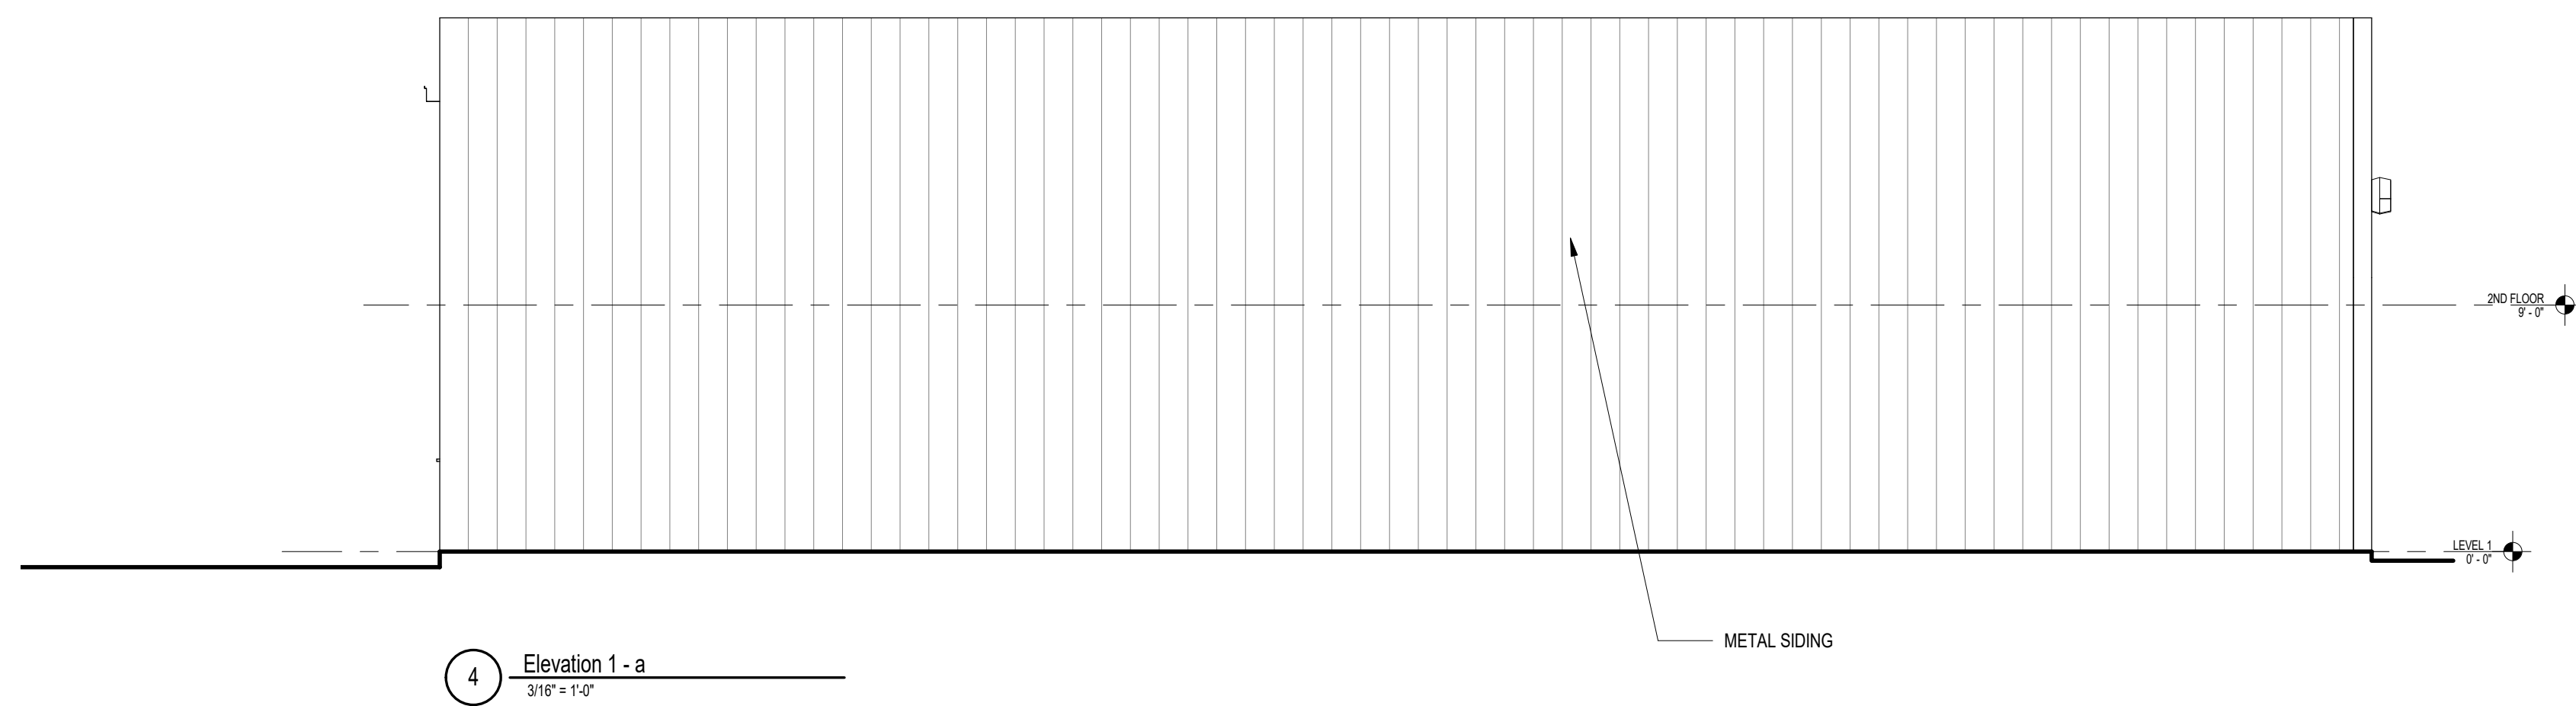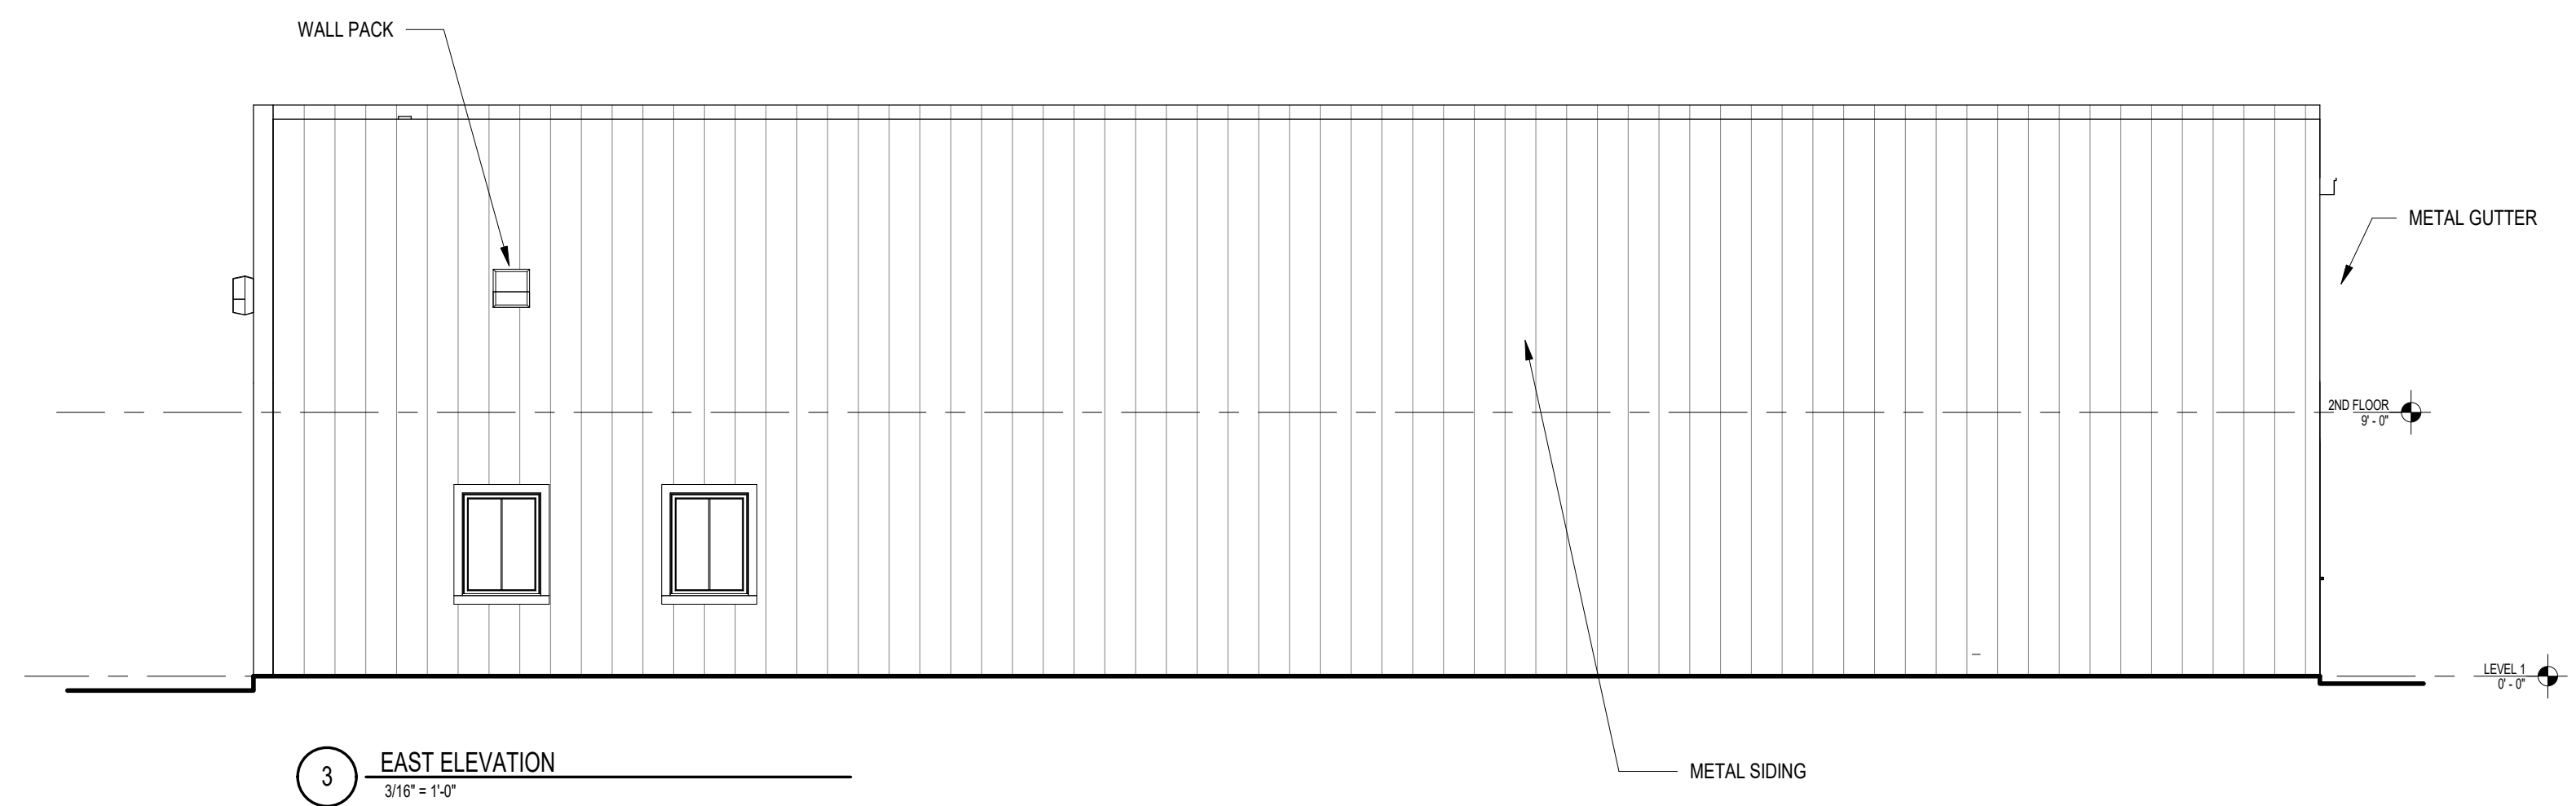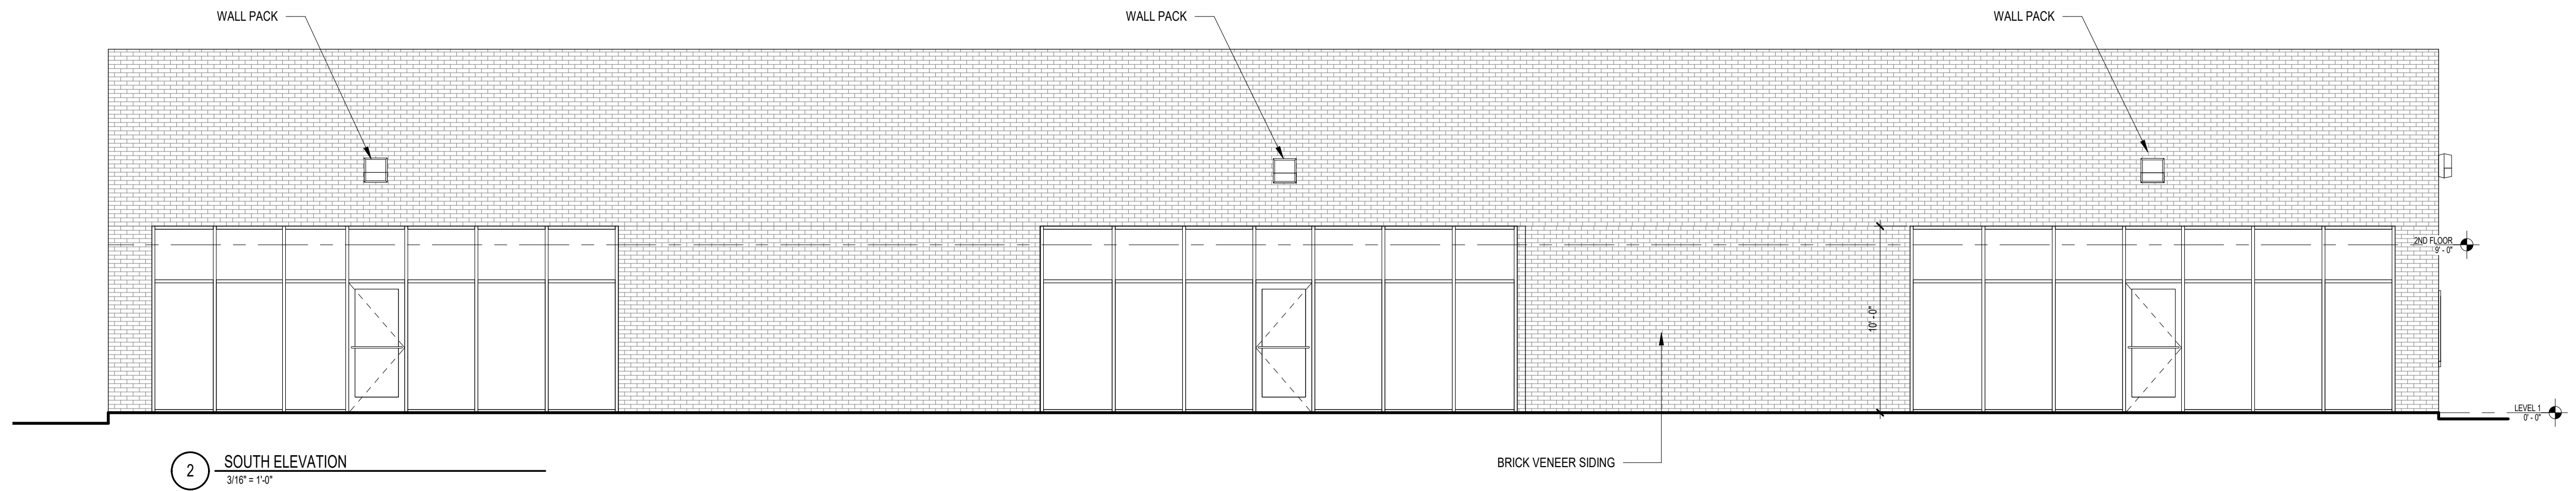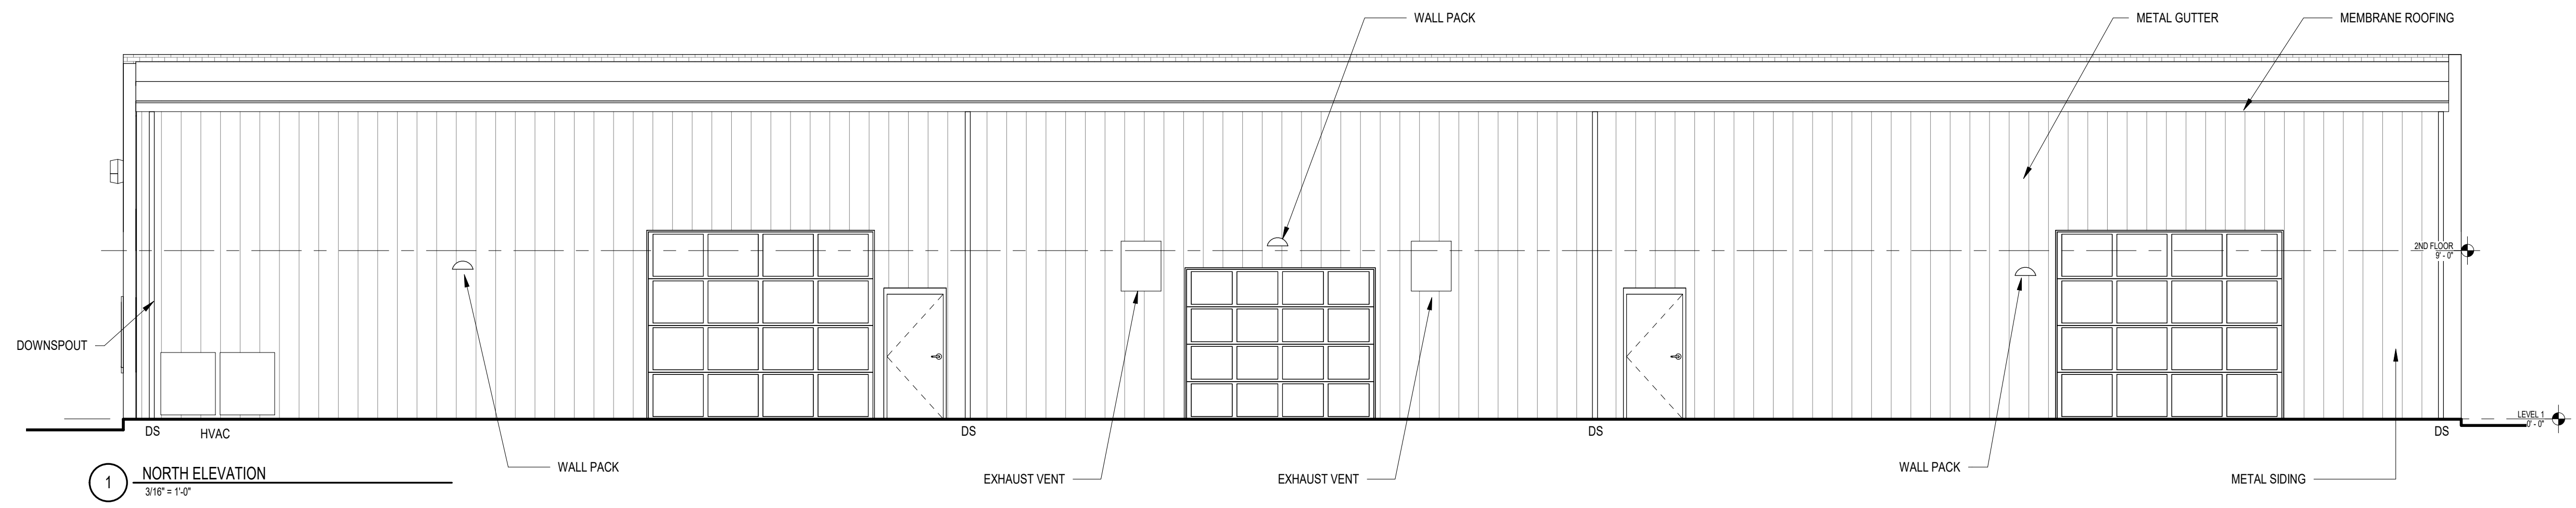


REVISIONS	DATE
AS-BUILTS	02/10/2023

NOT ISSUED FOR CONSTRUCTION


2317 DANBURY LANE,  
GAINESVILLE, GA

AS-BUILT DRAWINGS


ELEVATIONS

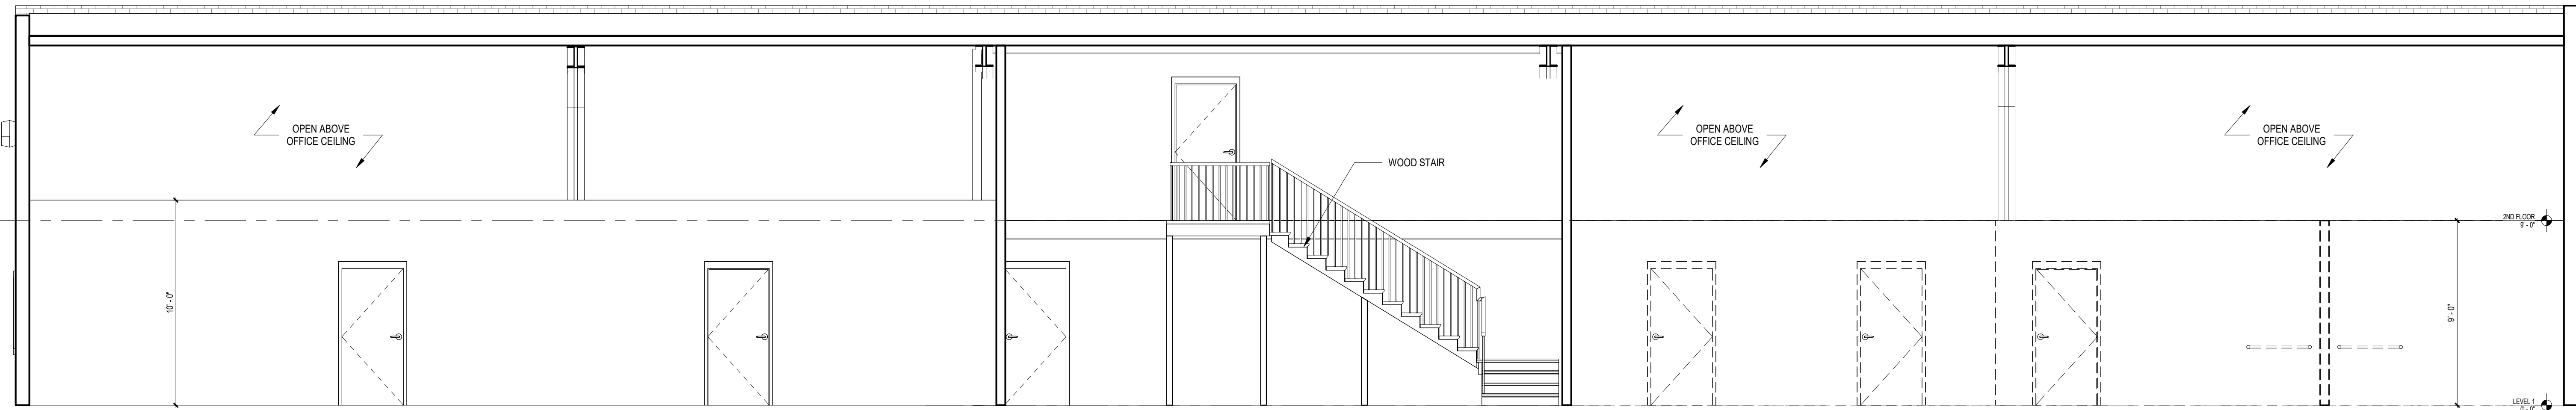

1 LONGITUDINAL SECTION  
1/4" = 1'-0"

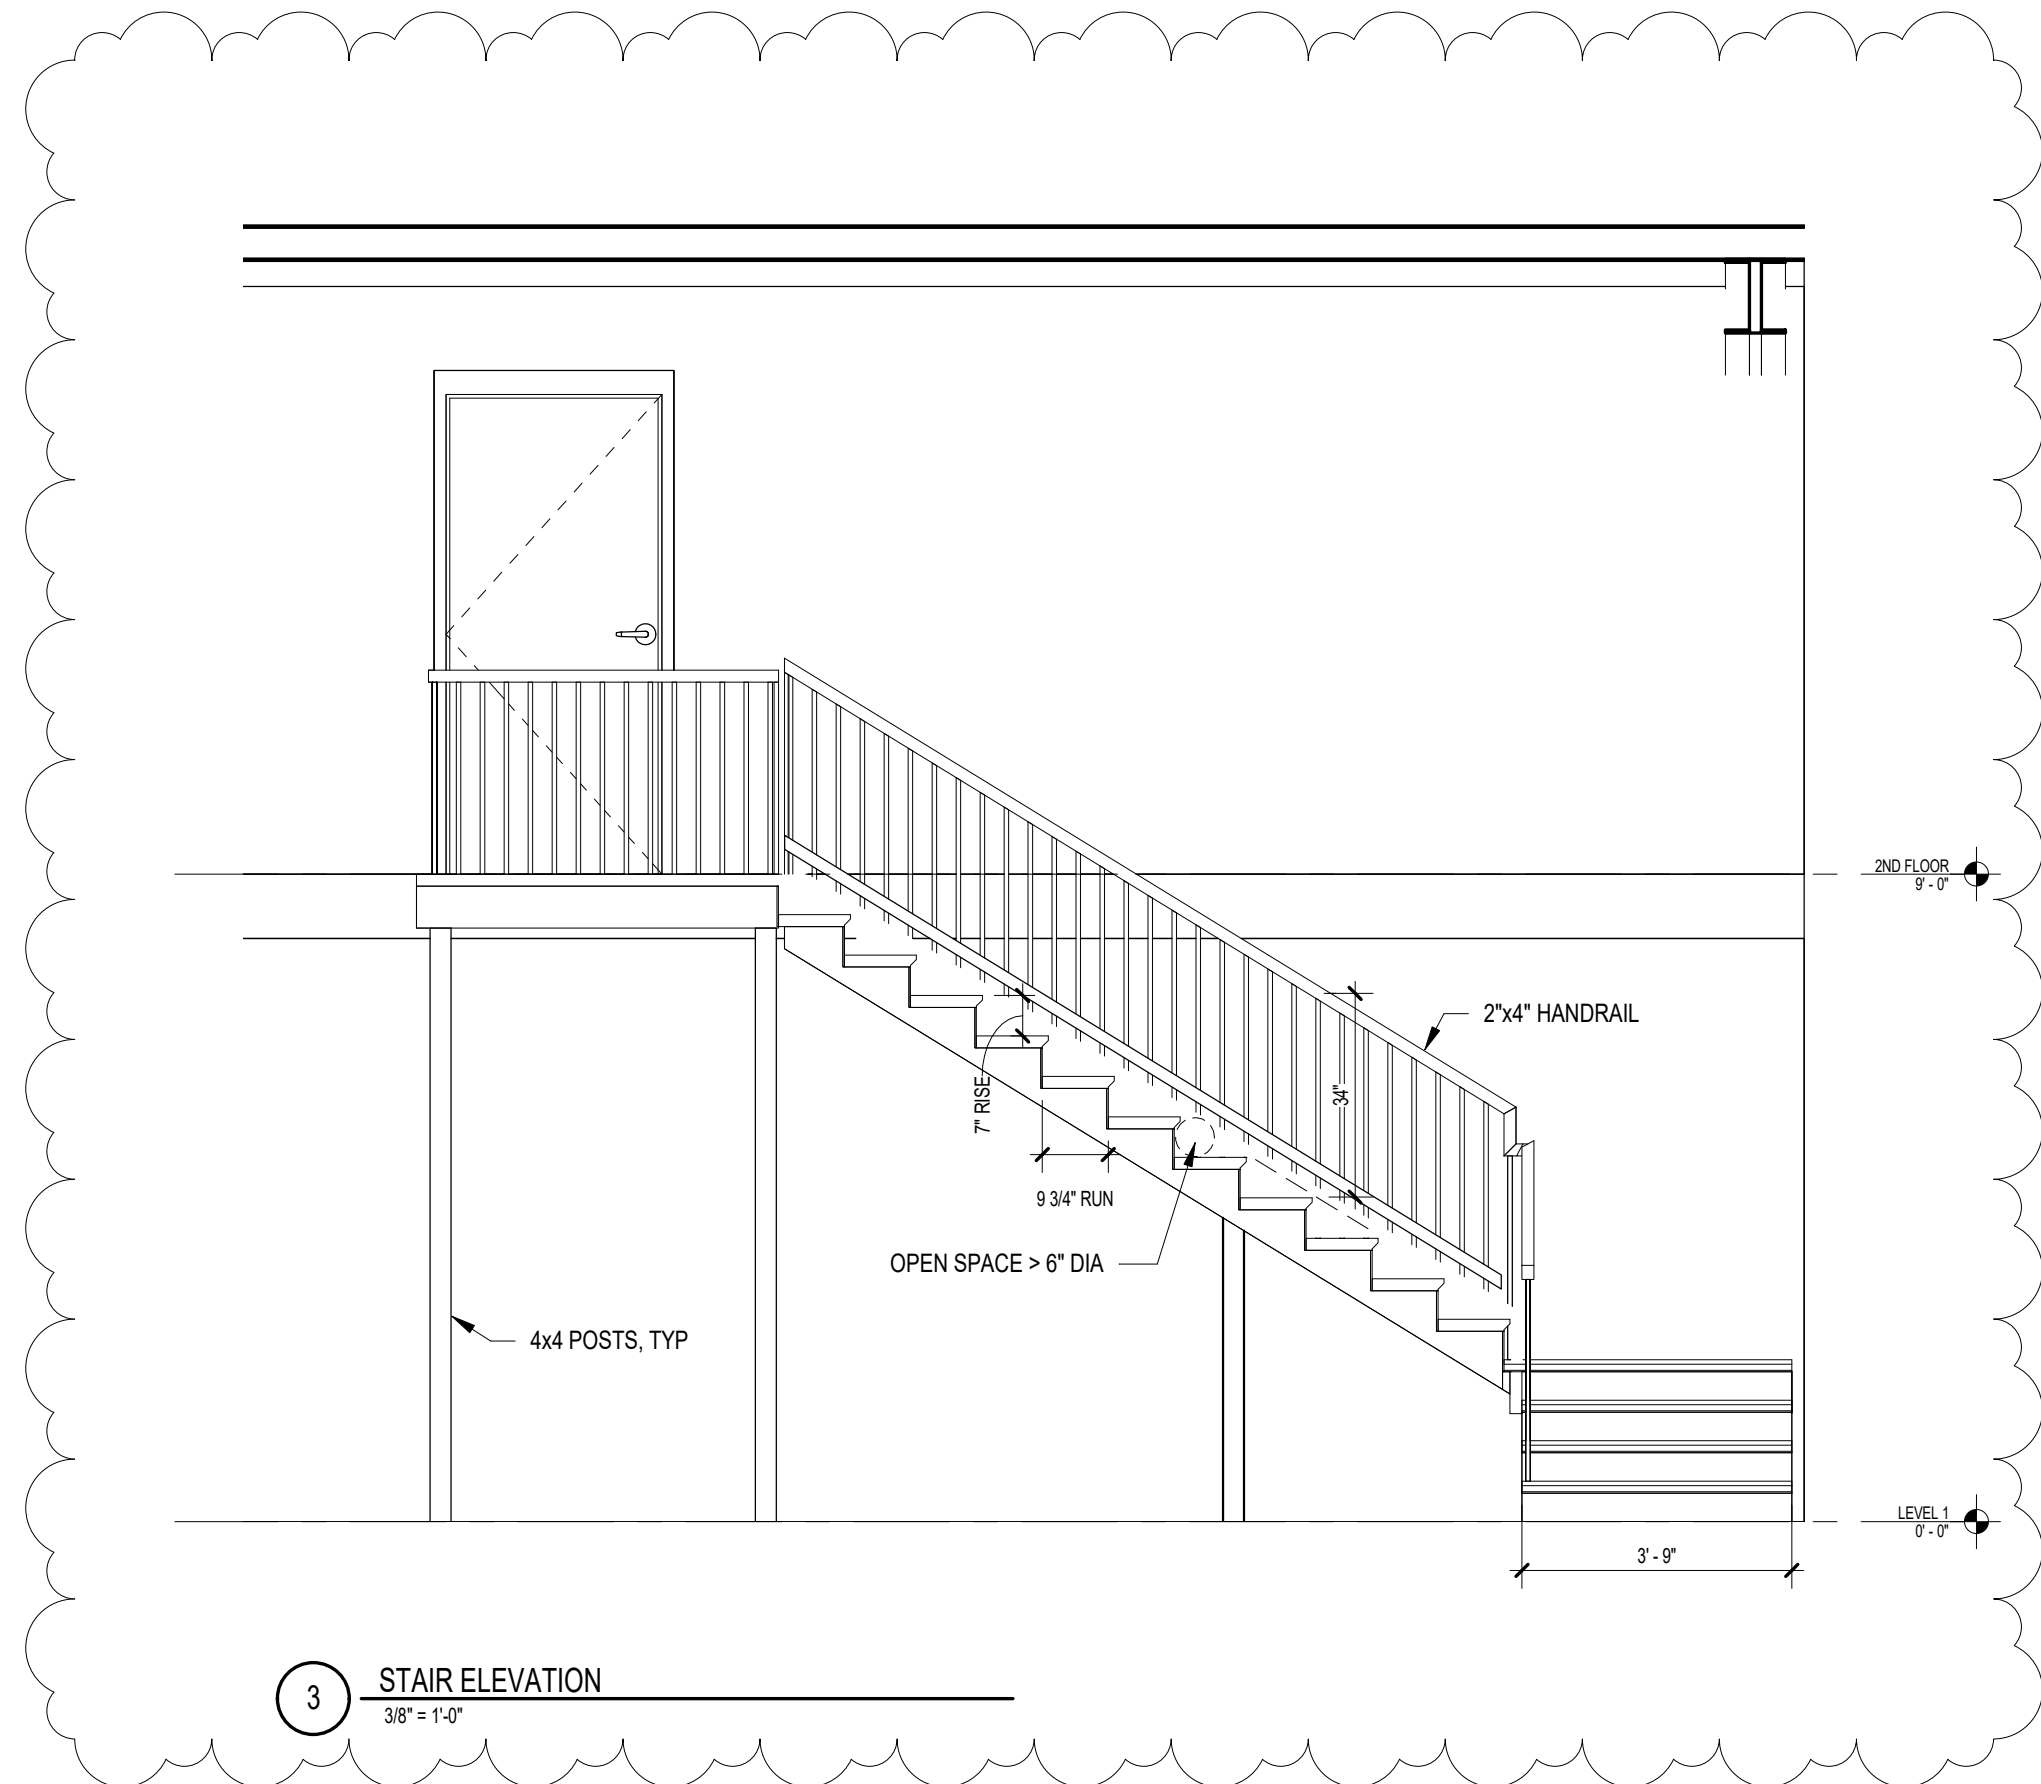

3 STAIR ELEVATION  
3/8" = 1'-0"

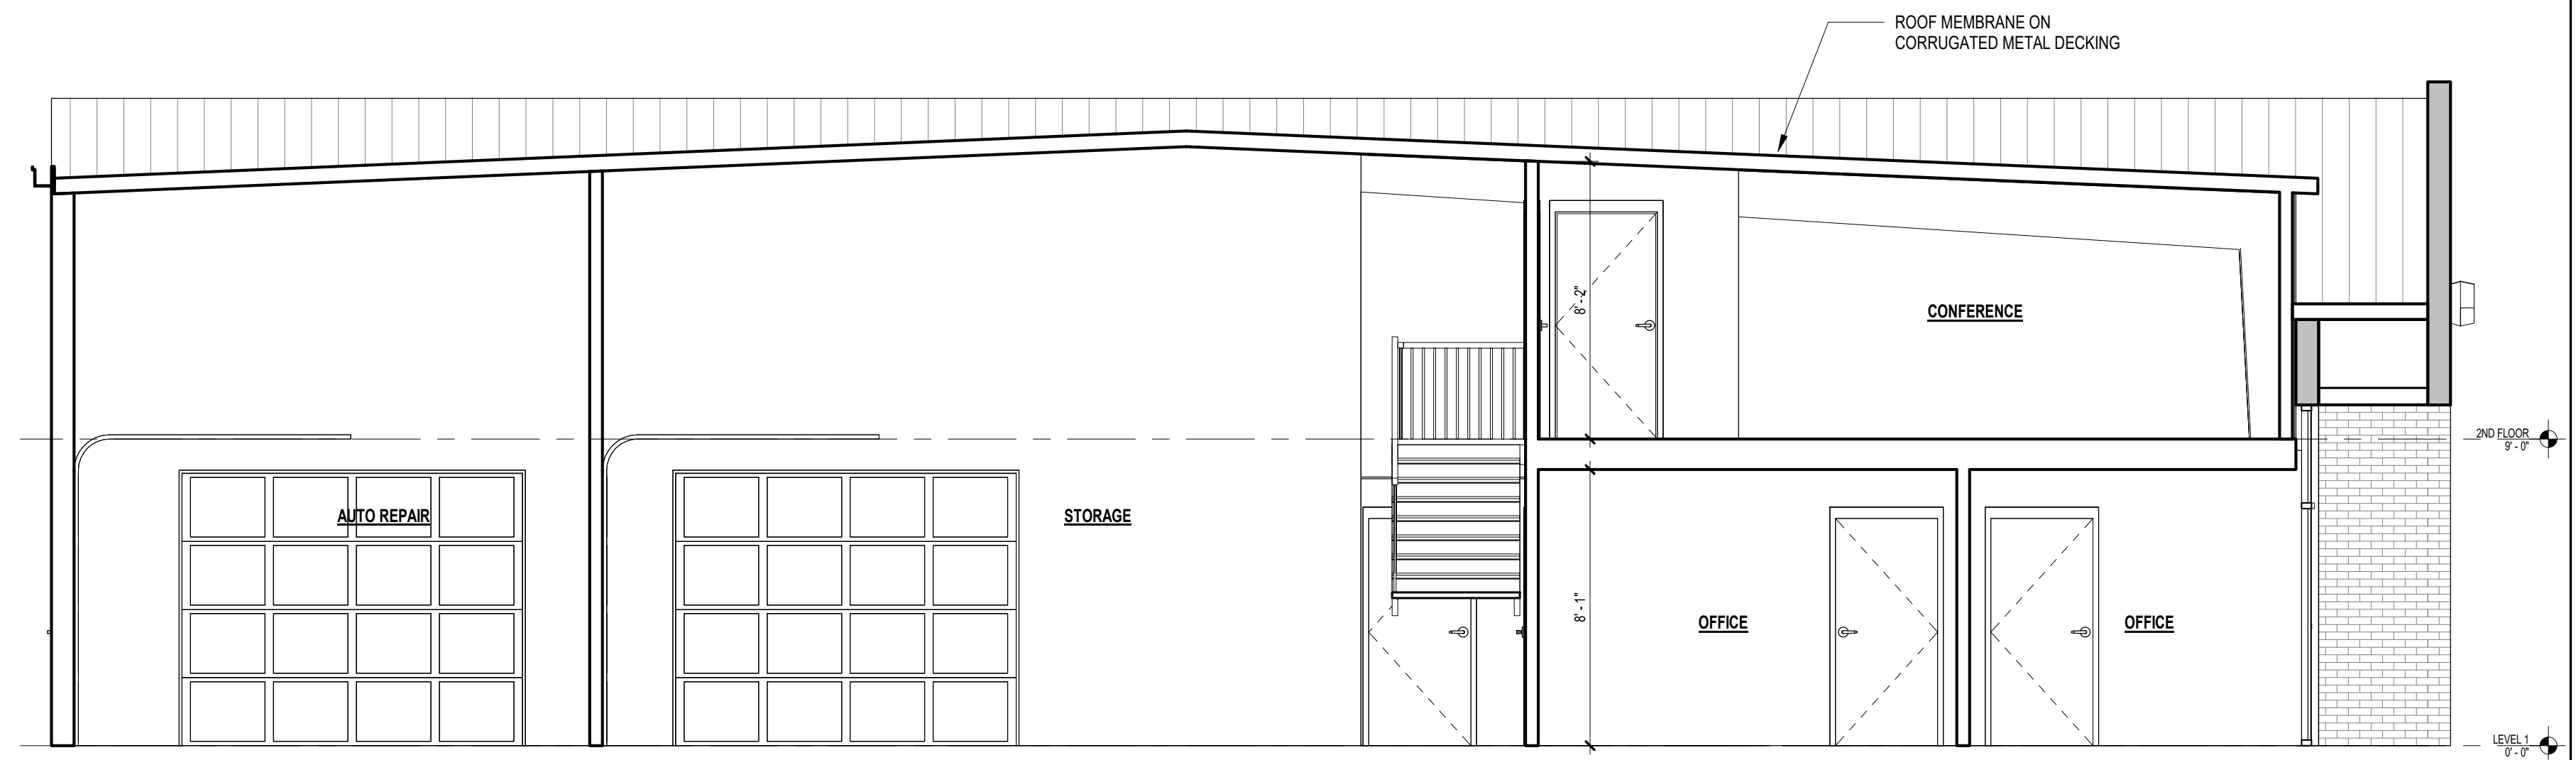

2 LATITUDINAL SECTION  
1/4" = 1'-0"

REVISION SUMMARY  
1. STAIR DETAILS

REVISIONS	DATE	BY	DESCRIPTION
AS-BUILTS	02/10/2023		
1 REV 1	02/17/23		

NOT ISSUED FOR CONSTRUCTION

2317 DANBURY LANE,  
GAINESVILLE, GA

AS-BUILT DRAWINGS

BUILDING SECTIONS